
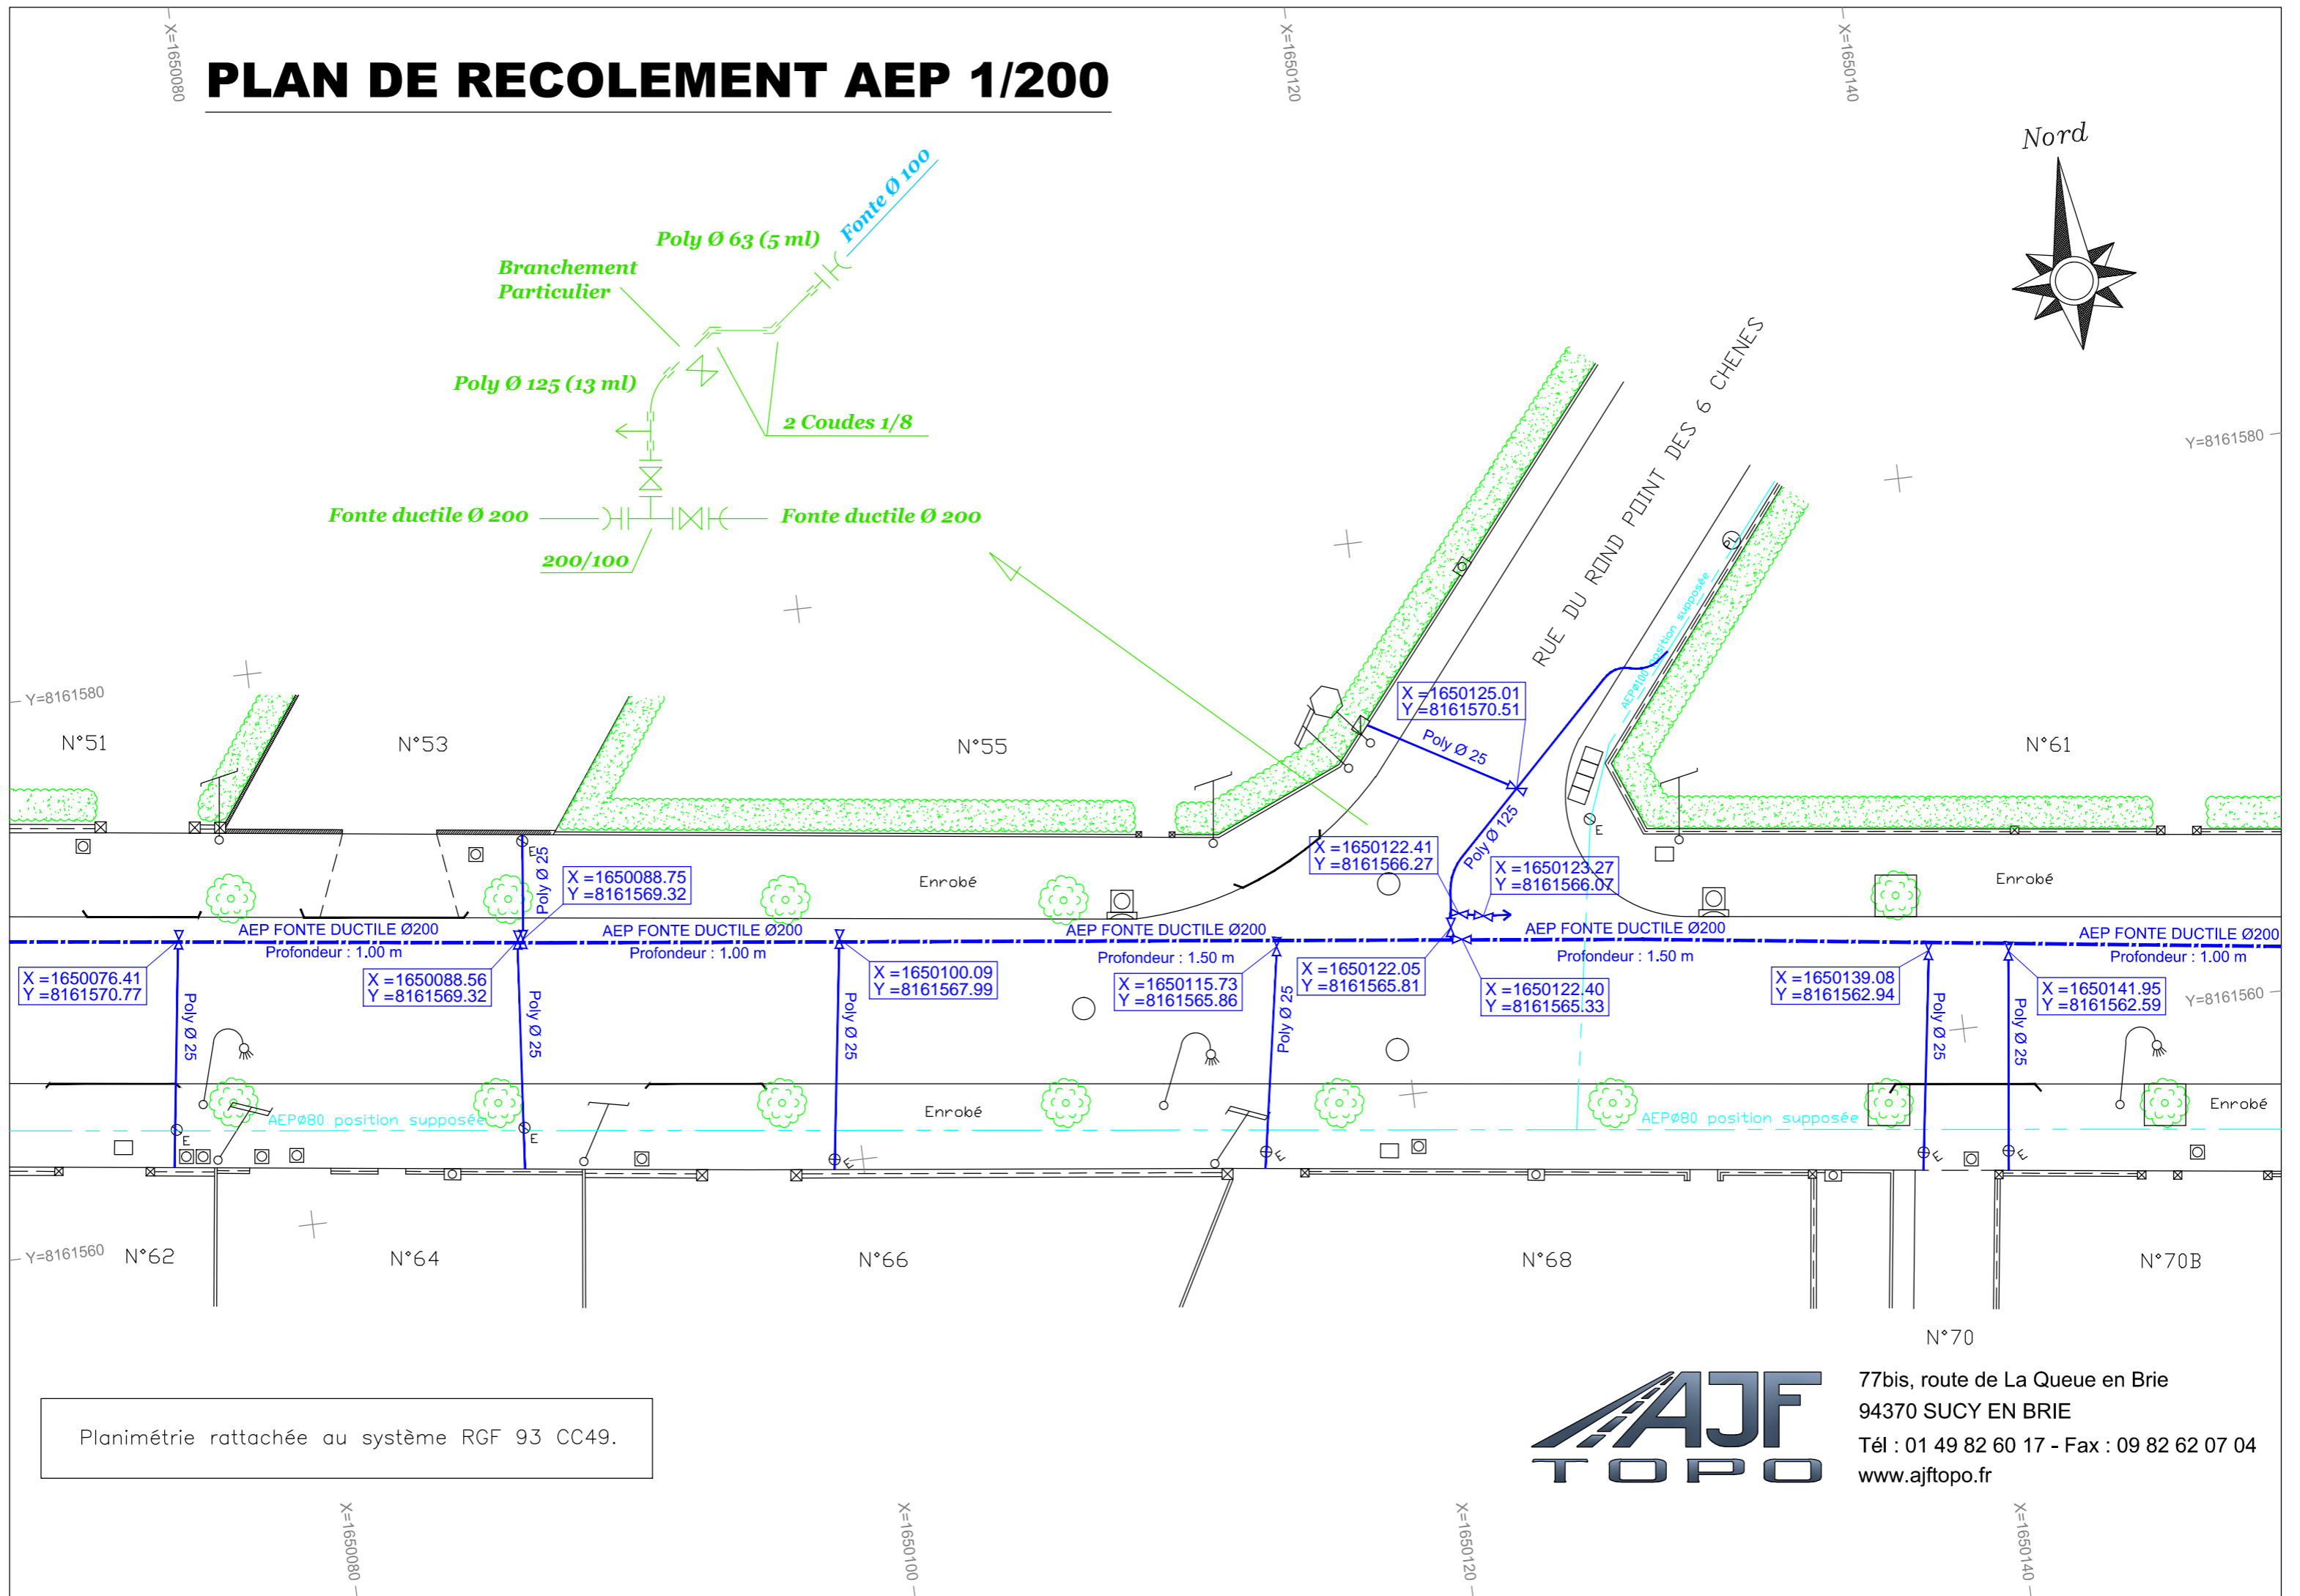


PLAN DE RECOLEMENT AEP 1/200

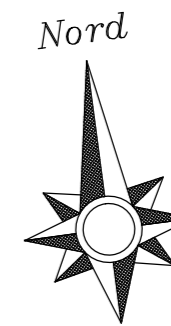

77bis, route de La Queue en Brie
 94370 SUCY EN BRIE
 Tél : 01 49 82 60 17 - Fax : 09 82 62 07 04
 www.ajftopo.fr